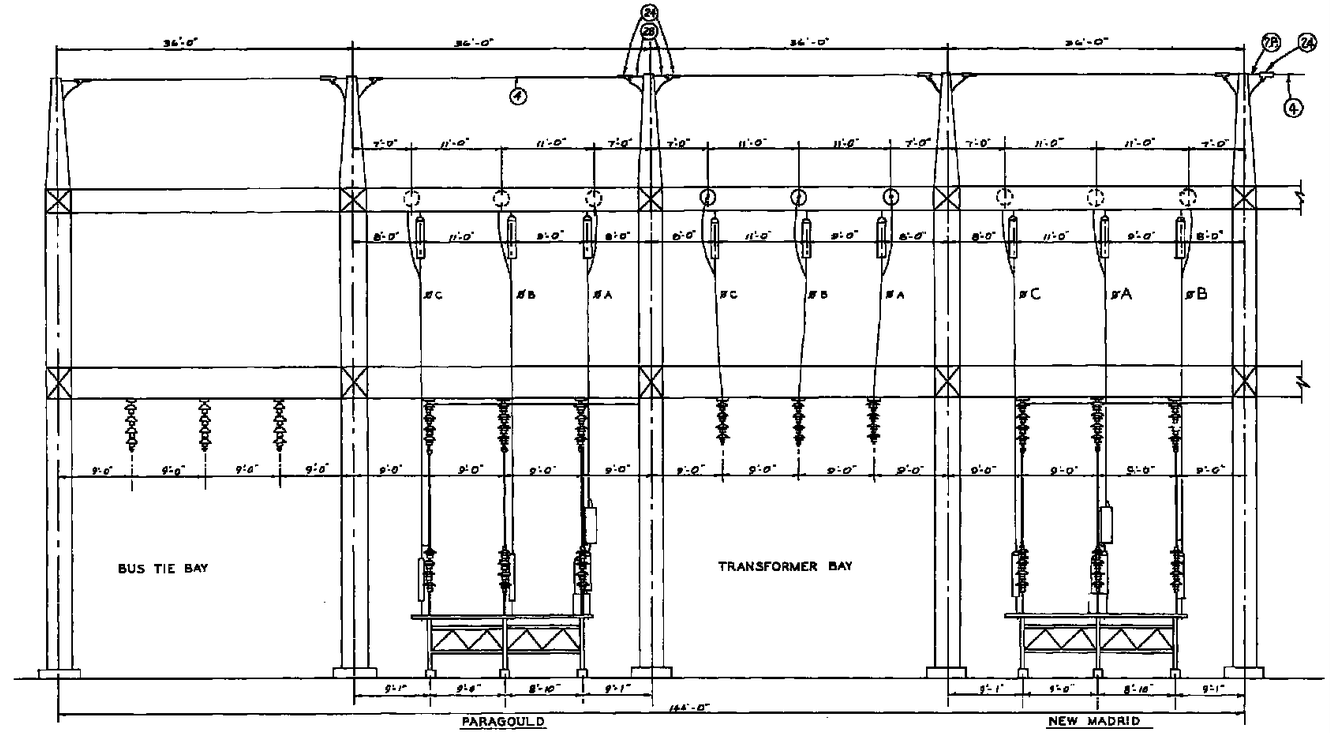

SECTION E-E
SCALE: 1/8"=1'-0"

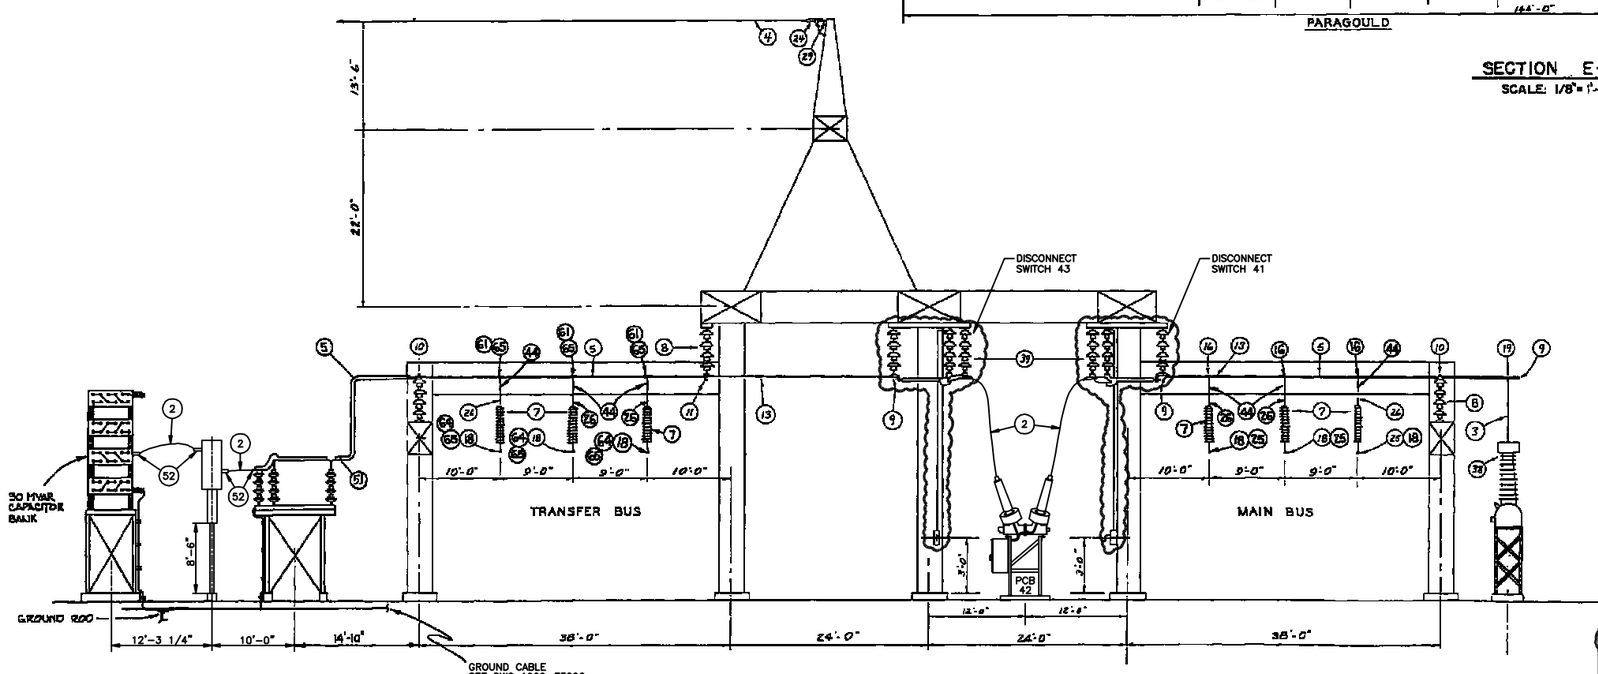

SECTION A-A
SCALE: 1/8"=1'-0"

WORK THIS CONTRACT

NOTE
1. FOR BILL OF MATERIAL ITEMS SEE DWG.# 1029-E4005

Reference Old drawing number: EE-M-1029-0036

REV	DESCRIPTION	DRWN	CHKD	APPROVED
8	SWITCH REPLACEMENTS	GBJ 10-05	KSH 10-05	
7	REVISED PER FIELD MARKS	MHJ 06-94	DLJ 06-94	
6	XFMR #2 AS-BUILT, SCANNED AND RENUMBERED	LPR 06-92	CEV 10-93	
5	AS-BUILT	CAH 07-90	GGP 07-90	
4	RECORD DRAWING	IEB 01-90	JB 02-90	
3	ADD CAPACITOR BANK	SWC 05-88	OKB 05-88	

UNITED STATES DEPARTMENT OF ENERGY
SOUTHWESTERN POWER ADMINISTRATION
TULSA, OKLAHOMA

KENNETT SUBSTATION
161KV STRUCTURE
ELECTRICAL SECTIONS "A-A" AND "E-E"

SCALE: NOTED
DRAWN: SWC
CHECKED:
SUBMITTED:
APPROVED:
DRAWING NUMBER: 1029-E4106
FILE NAME: E4106
SHEET NUMBER: 1 OF 1

8' 4' 0 8' 16'
SCALE: 1/8"=1'-0"

Border name: A1ASL201 Size: 36 x 24
Last Edited: 10/06/05 11:52:24 Last File Name: \\Pegasus\Drawings\Electrical_Stations\Kennett\A27060_-_Disconnect_Switch_Replacement_-_Scott_Holland\E4106_KEN.dwg
brian.johnson