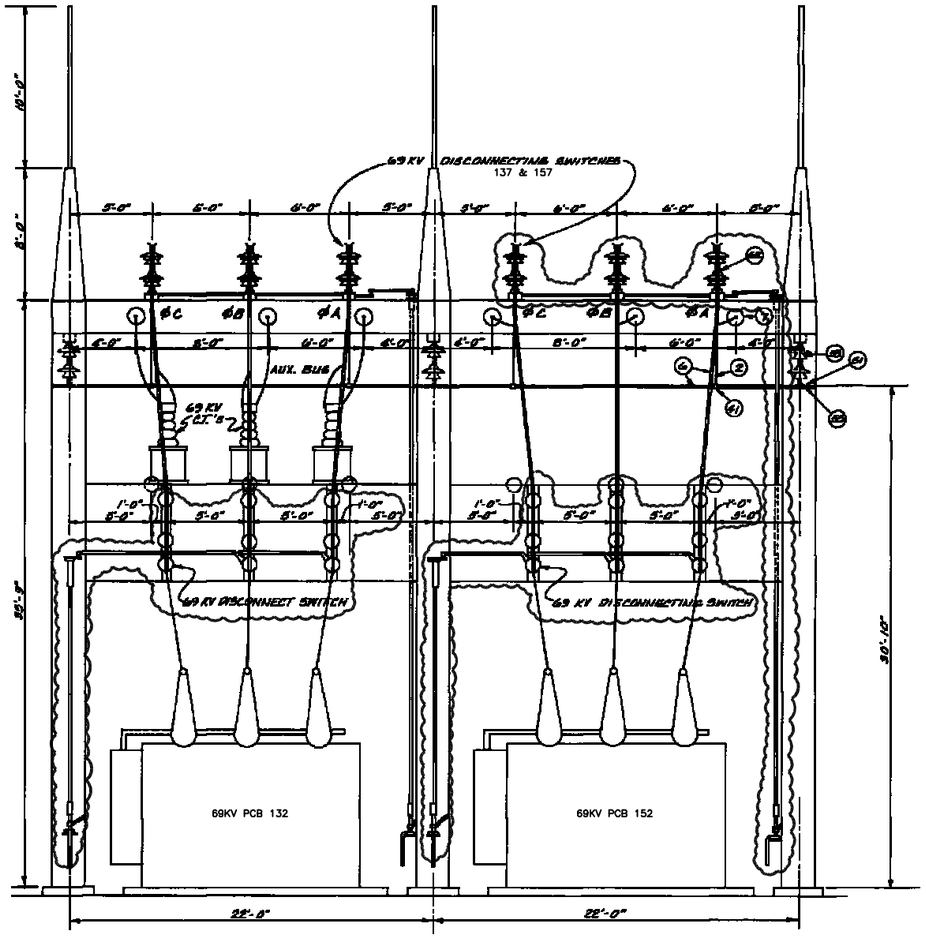

SECTION "A-A"

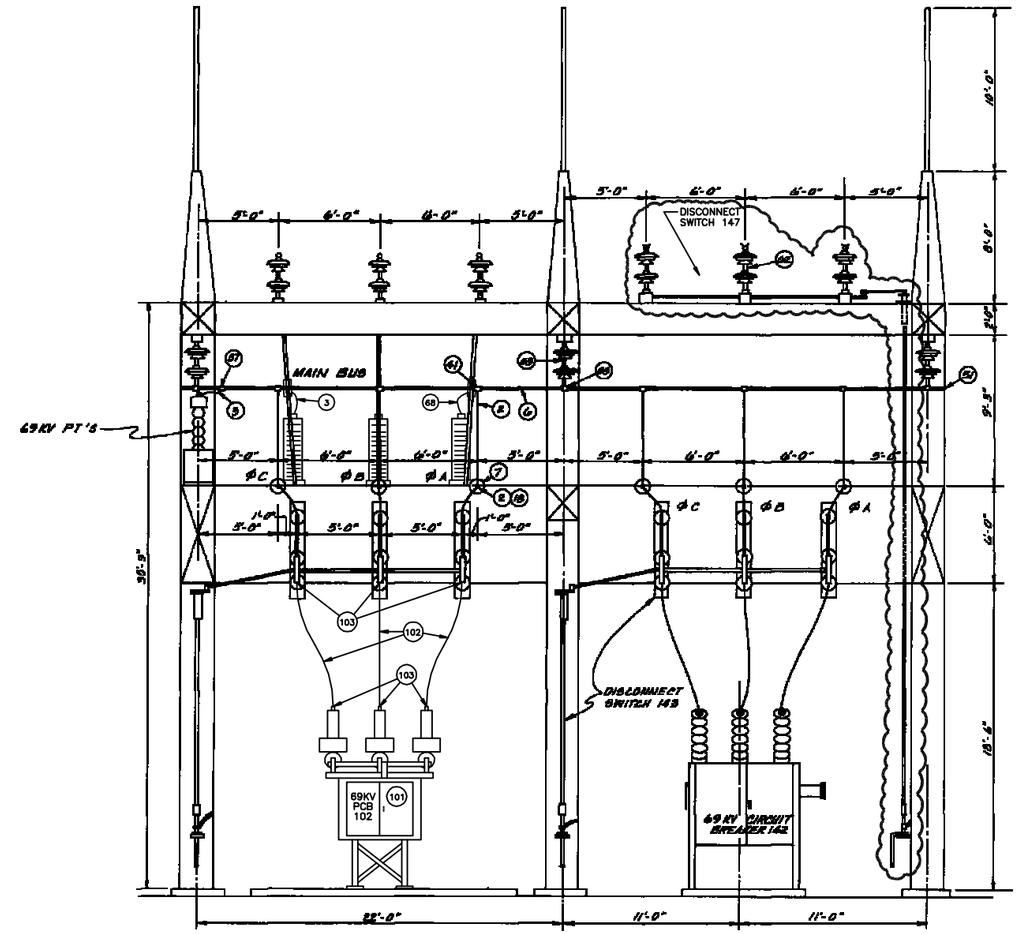

SECTION "B-B"

NOTES:

1. SEE DRAWING 1029-E4007 FOR PCB 102 MATERIAL LIST.

WORK THIS CONTRACT

Reference Old drawing number: EE-M-1029-0057

REV	DESCRIPTION	DRWN	CHKD
7	SWITCH REPLACEMENT	GBJ 10-05	KSH 10-05
6	PCB 102 REPLACEMENT	DKT 03-95	DEJ 02-96
5	REVISED PER FIELD MARKS	MHJ 06-94	DEJ 06-94
4	XFMR #2 AS-BUILT, SCANNED AND RENUMBERED	JRB 10-93	CEV 10-93
3	REVISED PER AS-BUILT COND. AND 1984 S/C MODIFICATIONS	RLD 05-87	ACL 06-87
2	ADDED PCB AND SWITCH, SECTION "B-B"	RAK 12-68	RAK 12-68

UNITED STATES DEPARTMENT OF ENERGY
SOUTHWESTERN POWER ADMINISTRATION
TULSA, OKLAHOMA

KENNETT SUBSTATION
69KV STRUCTURE
ELECTRICAL SECTIONS "A-A" AND "B-B"

SCALE	NOTED
DRAWN	RLD
CHECKED	
SUBMITTED	
APPROVED	

DRAWING NUMBER: 1029-E4116
FILE NAME: E4116
SHEET NUMBER: 1 OF 1

4' 2' 0 4' 8'
SCALE: 1/4"=1'-0"

Border name: A1ASL201 Size: 36 x 24
Last Edited: 10/06/05 13:12:10 Last File Name: \\Pegasus\Drawings\Electrical_Stations\Kennett\A27060_-_Disconnect_Switch_Replacement_-_Scott_Holland\E4116_KEN.dwg
brian.johnson